


CONTRACT DRAWINGS

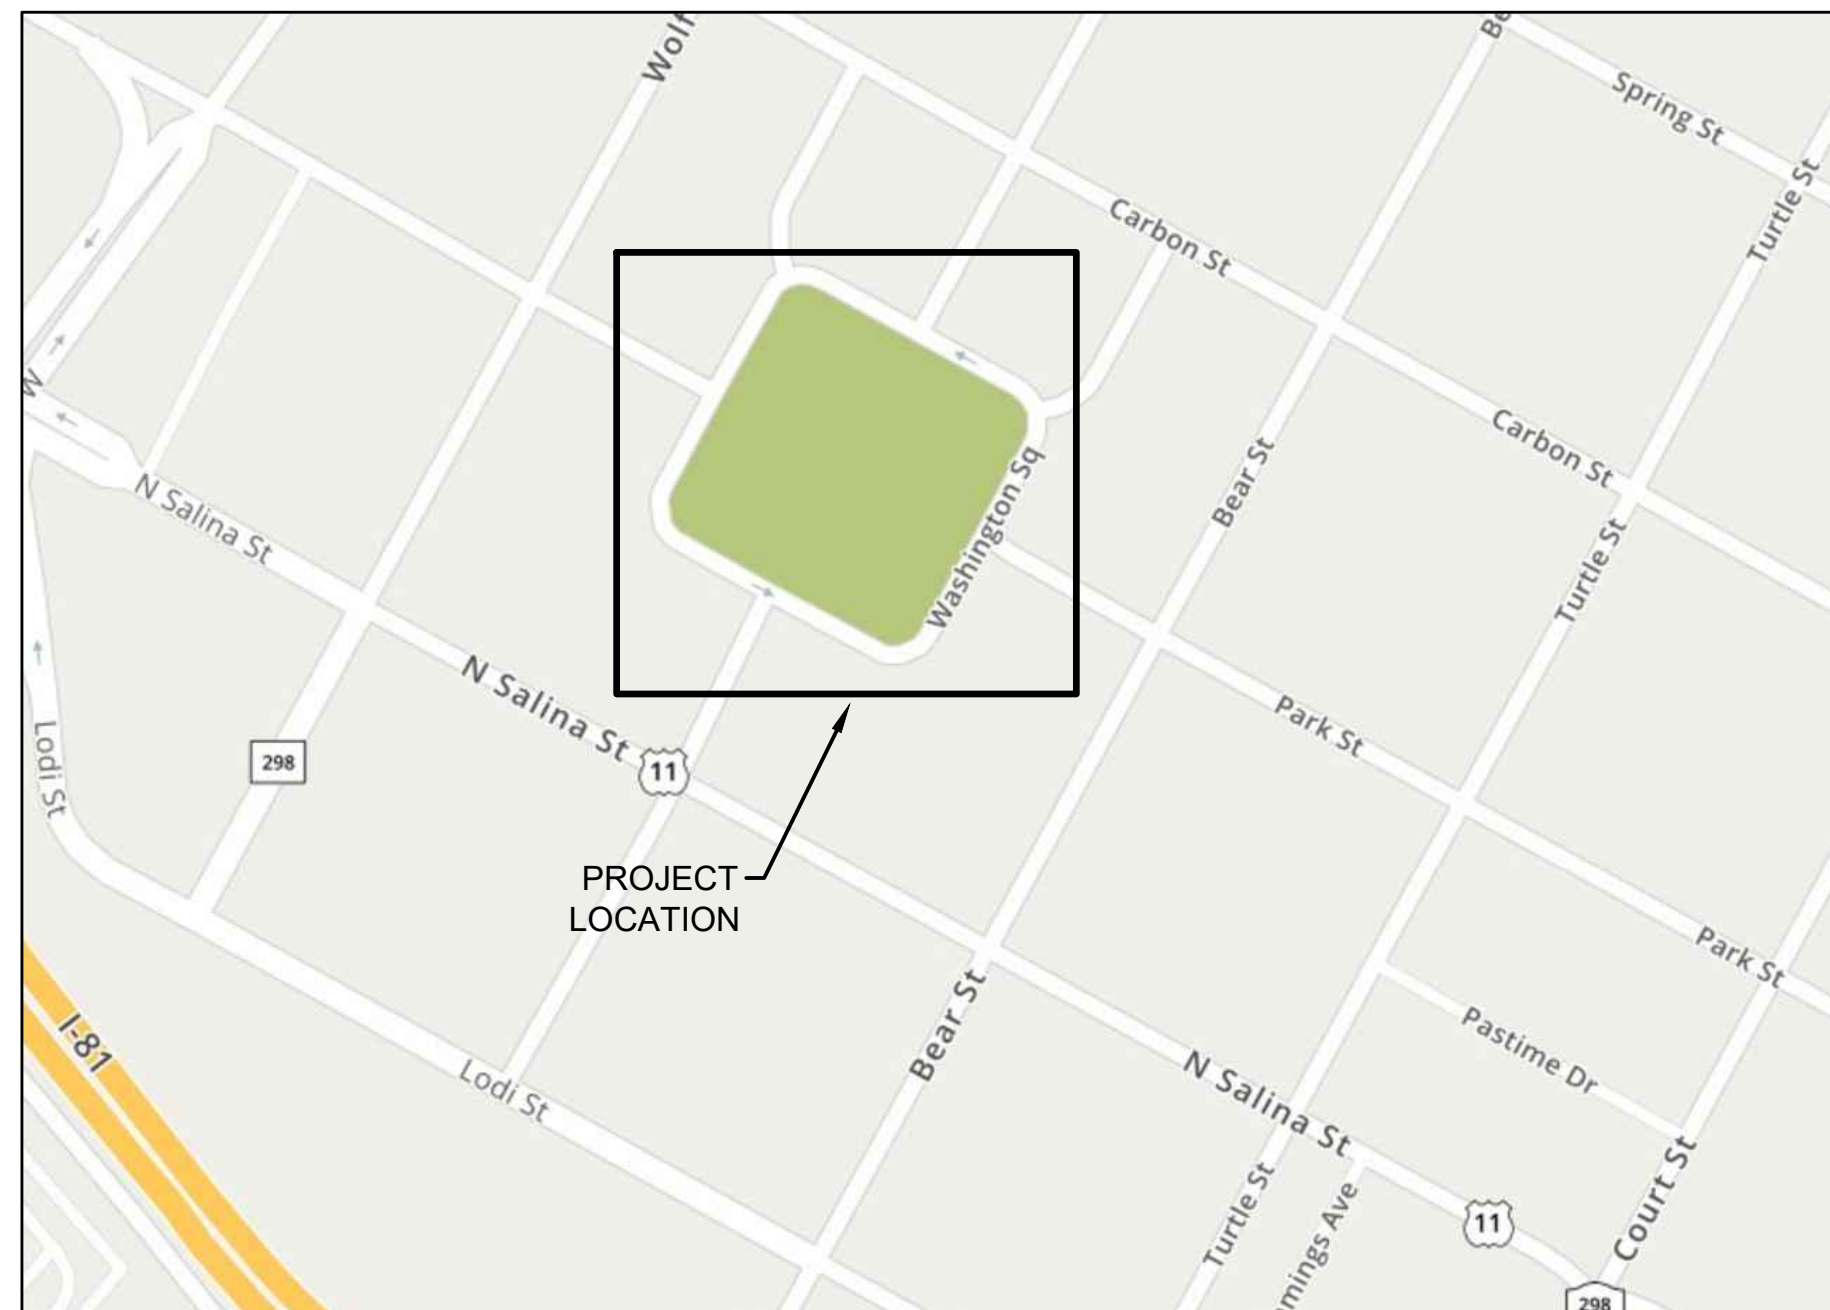

SITE LOCATION MAP
NOT TO SCALE

GREEN SITES CSO-075 WASHINGTON SQUARE PARK IMPROVEMENTS

TASK ORDER 2019-010G

TASK ORDER 2019-005L

INDEX TO DRAWINGS

	TITLE SHEET
C-001	GENERAL NOTES, LEGEND & ABBREVIATIONS
C-002	SITE DEMOLITION PLAN
C-003	DRAINAGE AREA MAP
C-101	SITE LAYOUT PLAN
C-102	GREEN INFRASTRUCTURE PLAN
C-501	DETAILS
C-502	HYDRAULIC PROFILES



**ONONDAGA COUNTY DEPARTMENT OF
WATER ENVIRONMENT PROTECTION
SYRACUSE, NEW YORK**

SEPTEMBER 2019



O'BRIEN & GERE ENGINEERS, INC.

333 WEST WASHINGTON STREET
SYRACUSE, NY 13202
PHONE: (315) 956-6100
FAX: (315) 463-7554



IT IS A VIOLATION OF LAW FOR ANY
PERSON UNLESS ACTING UNDER THE
DIRECTION OF A LICENSED PROFESSIONAL
ENGINEER TO ALTER THIS DOCUMENT.

RECORD DRAWINGS
To the best of our knowledge,
information and belief, these
record drawings substantially
represent the project as
constructed.

O'BRIEN & GERE
ENGINEERS, INC.

By: 



FRANK MENTO, COMMISSIONER
ONONDAGA COUNTY
DEPARTMENT OF WATER ENVIRONMENT PROTECTION
650 HIAWATHA BLVD., W
SYRACUSE, NY 13204

